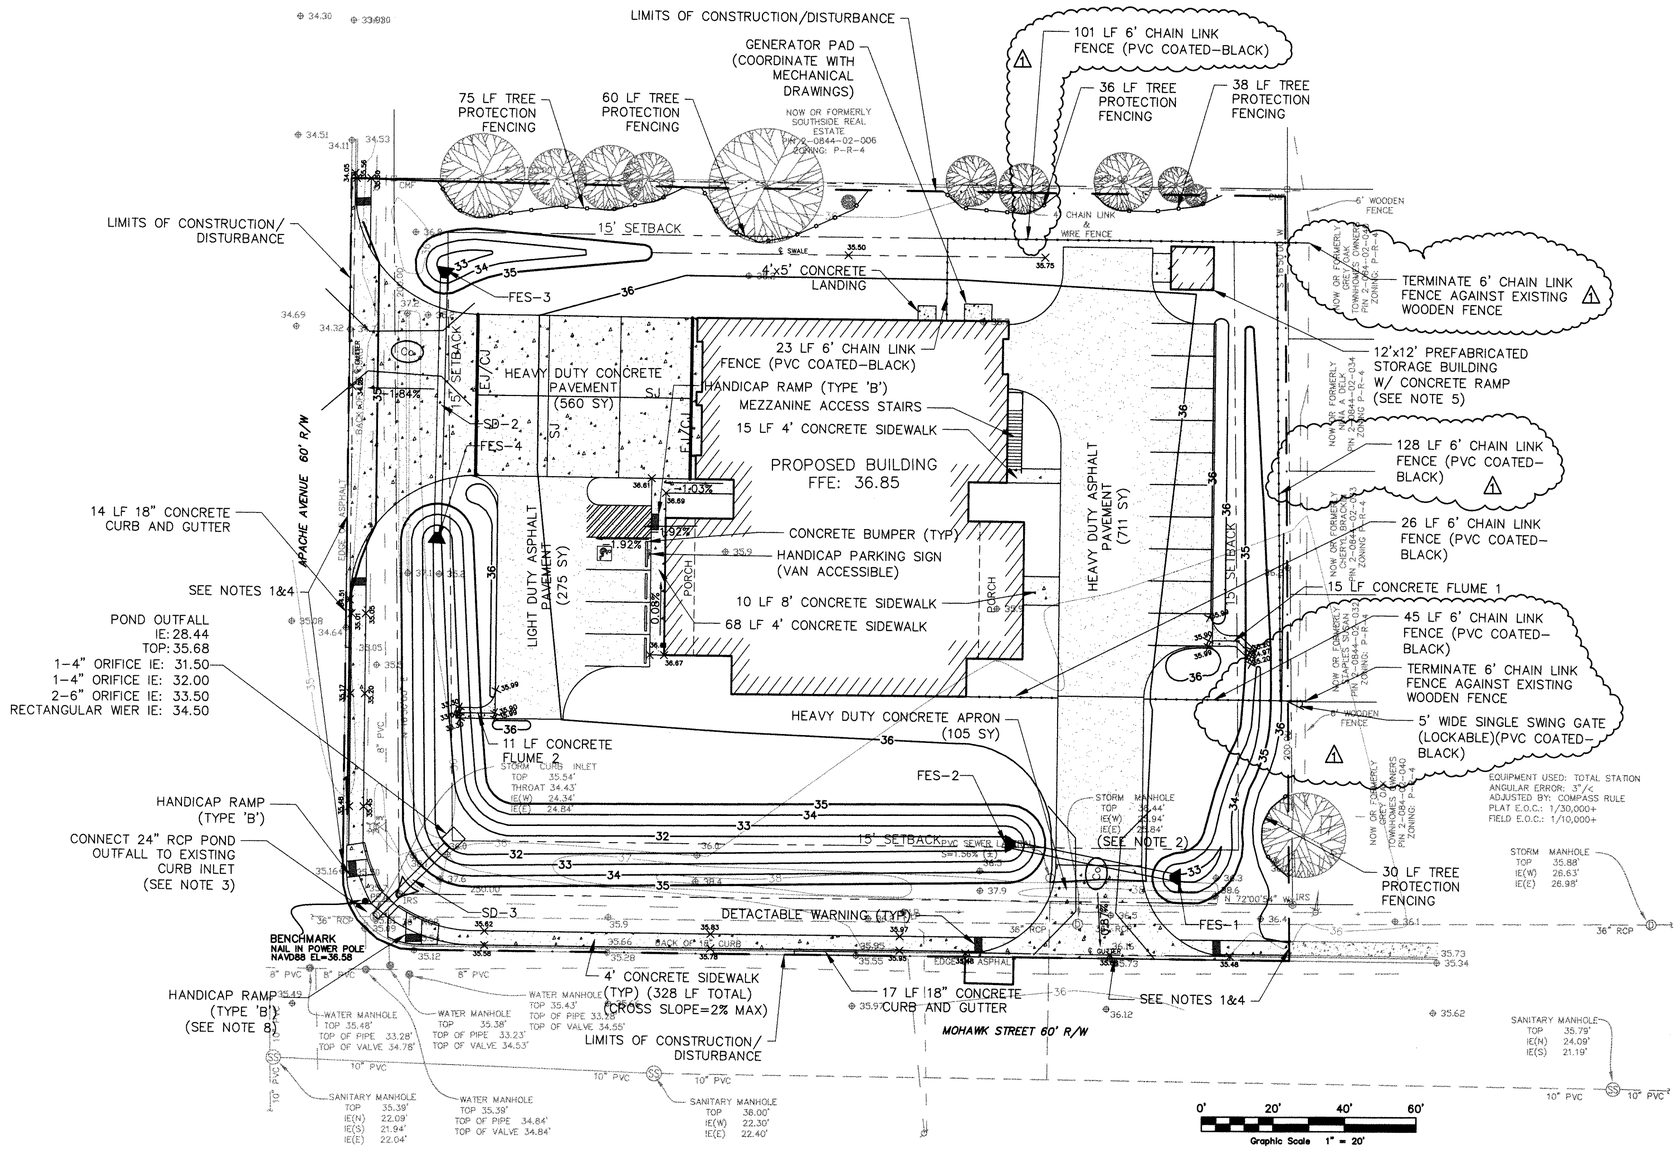

NOTES:

1. CONTRACTOR SHALL MATCH EXISTING PAVEMENT ELEVATIONS AT EDGE OF NEW CONSTRUCTION.
2. CONTRACTOR SHALL ADJUST RIM ELEVATION TO MATCH FINISHED SURFACE OF NEW CONCRETE APRON.
3. CONTRACTOR SHALL SAWCUT EXISTING STRUCTURE AS REQUIRED TO CONNECT 24" RCP POND OUTFALL. PENETRATION SHALL BE SEALED/FINISHED WITH BRICK AND NON-SHRINK GROUT.
4. CONTRACTOR SHALL REMOVE CURB AND GUTTER TO EXTENT REQUIRED TO INSTALL NEW DRIVEWAYS AND HANDICAP RAMP. EXTENT OF REMOVAL SHALL ALLOW TAPERING OF EXISTING CURB AT EDGE OF DRIVEWAY AND HANDICAP RAMP. CONTRACTOR SHALL INSTALL CURBING TAPERS AT THE EDGE OF NEW DRIVEWAYS AND HANDICAP RAMP.
5. CONCRETE RAMP SHALL BE CONSTRUCTED TO ALLOW FOR SMOOTH TRANSITION FROM ASPHALT PAVEMENT TO PREFABRICATED BUILDING'S FINISHED FLOOR. CONCRETE SHALL BE 3000 PSI MINIMUM. CONCRETE RAMP DIMENSIONS SHALL BE APPROVED BY OWNER OR ENGINEER PRIOR TO STORAGE BUILDING PLACEMENT AND RAMP CONSTRUCTION.
6. CONTRACTOR SHALL NOT DISCHARGE CHLORINATED DISINFECTED WATER INTO THE STORMWATER SYSTEM.
7. CONTRACTOR SHALL TELEVISE STORMWATER FACILITIES IN ACCORDANCE WITH THE CITY OF SAVANNAH'S NEW CONSTRUCTION TELEVISING PROCEDURES MANUAL.
8. CONTRACTOR SHALL INSTALL HANDICAP RAMP ON EXISTING SIDEWALK ON SOUTH SIDE OF MOHAWK STREET. HANDICAP RAMP SHALL BE TYPE 'B' AND ITS LOCATION SHALL BE APPROVED BY OWNER PRIOR TO INSTALLATION.

PAVING, GRADING AND DRAINAGE PLAN

1 = 20'-0"

NORTH

IF YOU DIG GEORGIA...
CALL US FIRST!
UTILITIES PROTECTION CENTER
1-800-282-7411
IT'S THE LAW

ATLANTIC COAST CONSULTING, INC.
7 E Congress Street
Suite 801
Savannah, GA 31401
o:912.236.3471
f: 912.236.3472
www.atlcc.net

Cert # 06930

WATKINS ASSOCIATES ARCHITECTS
35 Abercorn Street, Suite 220
Savannah, Georgia, 31401

THE CONCEPTS, DESIGNS, PLANS, SPECIFICATIONS, AND REPORTS AS INSTRUMENTS OF SERVICE, ARE AND SHALL REMAIN THE PROPERTY OF WATKINS ASSOCIATES ARCHITECTS, INC. WHETHER THE PROJECT FOR WHICH THEY ARE MADE IS EXECUTED OR NOT. THE REPRODUCTION, PUBLICATION OR USE OF THESE DESIGNS, PLANS, SPECIFICATIONS, OR OTHER DOCUMENTS WITHOUT WRITTEN PERMISSION IS PROHIBITED. VISUAL CONTACT WITH THESE DESIGNS, PLANS, SPECIFICATIONS, OR OTHER DOCUMENTS SHALL CONSTITUTE PROOF OF ACCEPTANCE OF THESE RESTRICTIONS. THESE DESIGNS SHALL BE REMARKED UPON WRITTEN REQUEST.
COPYRIGHT 2006
WATKINS ASSOCIATES ARCHITECTS, INC.

SFES - FIRE STATION NO. 11

1066 MOHAWK STREET, SAVANNAH, GEORGIA
CHATHAM COUNTY

MAL	DRAWN BY
JT	CHECKED BY
04.03.10	DATE
05.16.10	REVISION DATE
A010-102	PROJECT NO.

C1.0

PAVING, GRADING AND DRAINAGE PLAN